


LEGEND

- RIGHT-OF-WAY LINE
- - - CURBLINE
- SANITARY SEWER
- STORM SEWER
- |—|— WATER LINE
- |—|— GAS LINE
- |—|— TELEPHONE LINE
- LIGHT
- UTILITY POLE
- ▲ FLARED END SECTION
- HYDRANT
- WATER VALVE
- GAS VALVE

ONE STORY
OFFICE / WAREHOUSE
BUILDING
114.0 F.F.

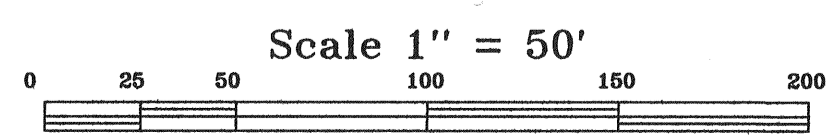

REVISIONS


NO.	DESCRIPTION	DATE	BY
3	As Built Information Added	7-22-05	4
4	Additional Information Added	8-31-05	
1	Survey Updated	11-4-04	2
2	New Door Locations Added	5-2-05	

ALTA/ACSM LAND
TITLE SURVEY

300 HERROD BOULEVARD
TAX LOT 15.03, BLOCK 11.05
TAX MAP SHEET 4

TOWNSHIP OF SOUTH BRUNSWICK
MIDDLESEX COUNTY, NEW JERSEY

CASEY &

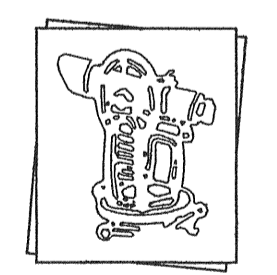

**KELLER
INCORPORATED**

NI State Board of Professional Engineers & Land
Surveyors Certificate of Authorization # 240427985400

**CIVIL ENGINEERS
LAND SURVEYORS**

258 Main Street, PO Box 191
Millburn, New Jersey 07041
973-379-3280 Fax: 973-379-7993

MICHAEL T. LANZAFAMA

Michael Lanzafama
DATE 10-13-2004
New Jersey Professional Engineer & Land Surveyor No. 30084

1" = 50'	CAD	RP-H
SCALE	FIELD BOOK	DRAWN BY
1040537	DESC.	DWG. NO.
JOB NO.	MAP NO.	

PLAT FILE NO.: 2885